

No.	Description	Date
1	Construction Related	06/21/2013
36	Owner Requested Revisions: Panel Docking Modifications	09/15/2015
37	Record Drawings	01/29/2016
38	Panel Revision	04/01/2016

100% CONSTRUCTION DOCUMENT PACKAGE


© COPYRIGHT 2011 DWL ARCHITECTS + PLANNERS, INC.

KEY:

SHEET TITLE:
LOWER ROOF FRAMING PLAN


SHEET NUMBER:
S 210

DRAWN BY: MSM	REVIEWED BY: RHG
DATE: 2012.05.07	PROJECT NUMBER: 5011.11.05

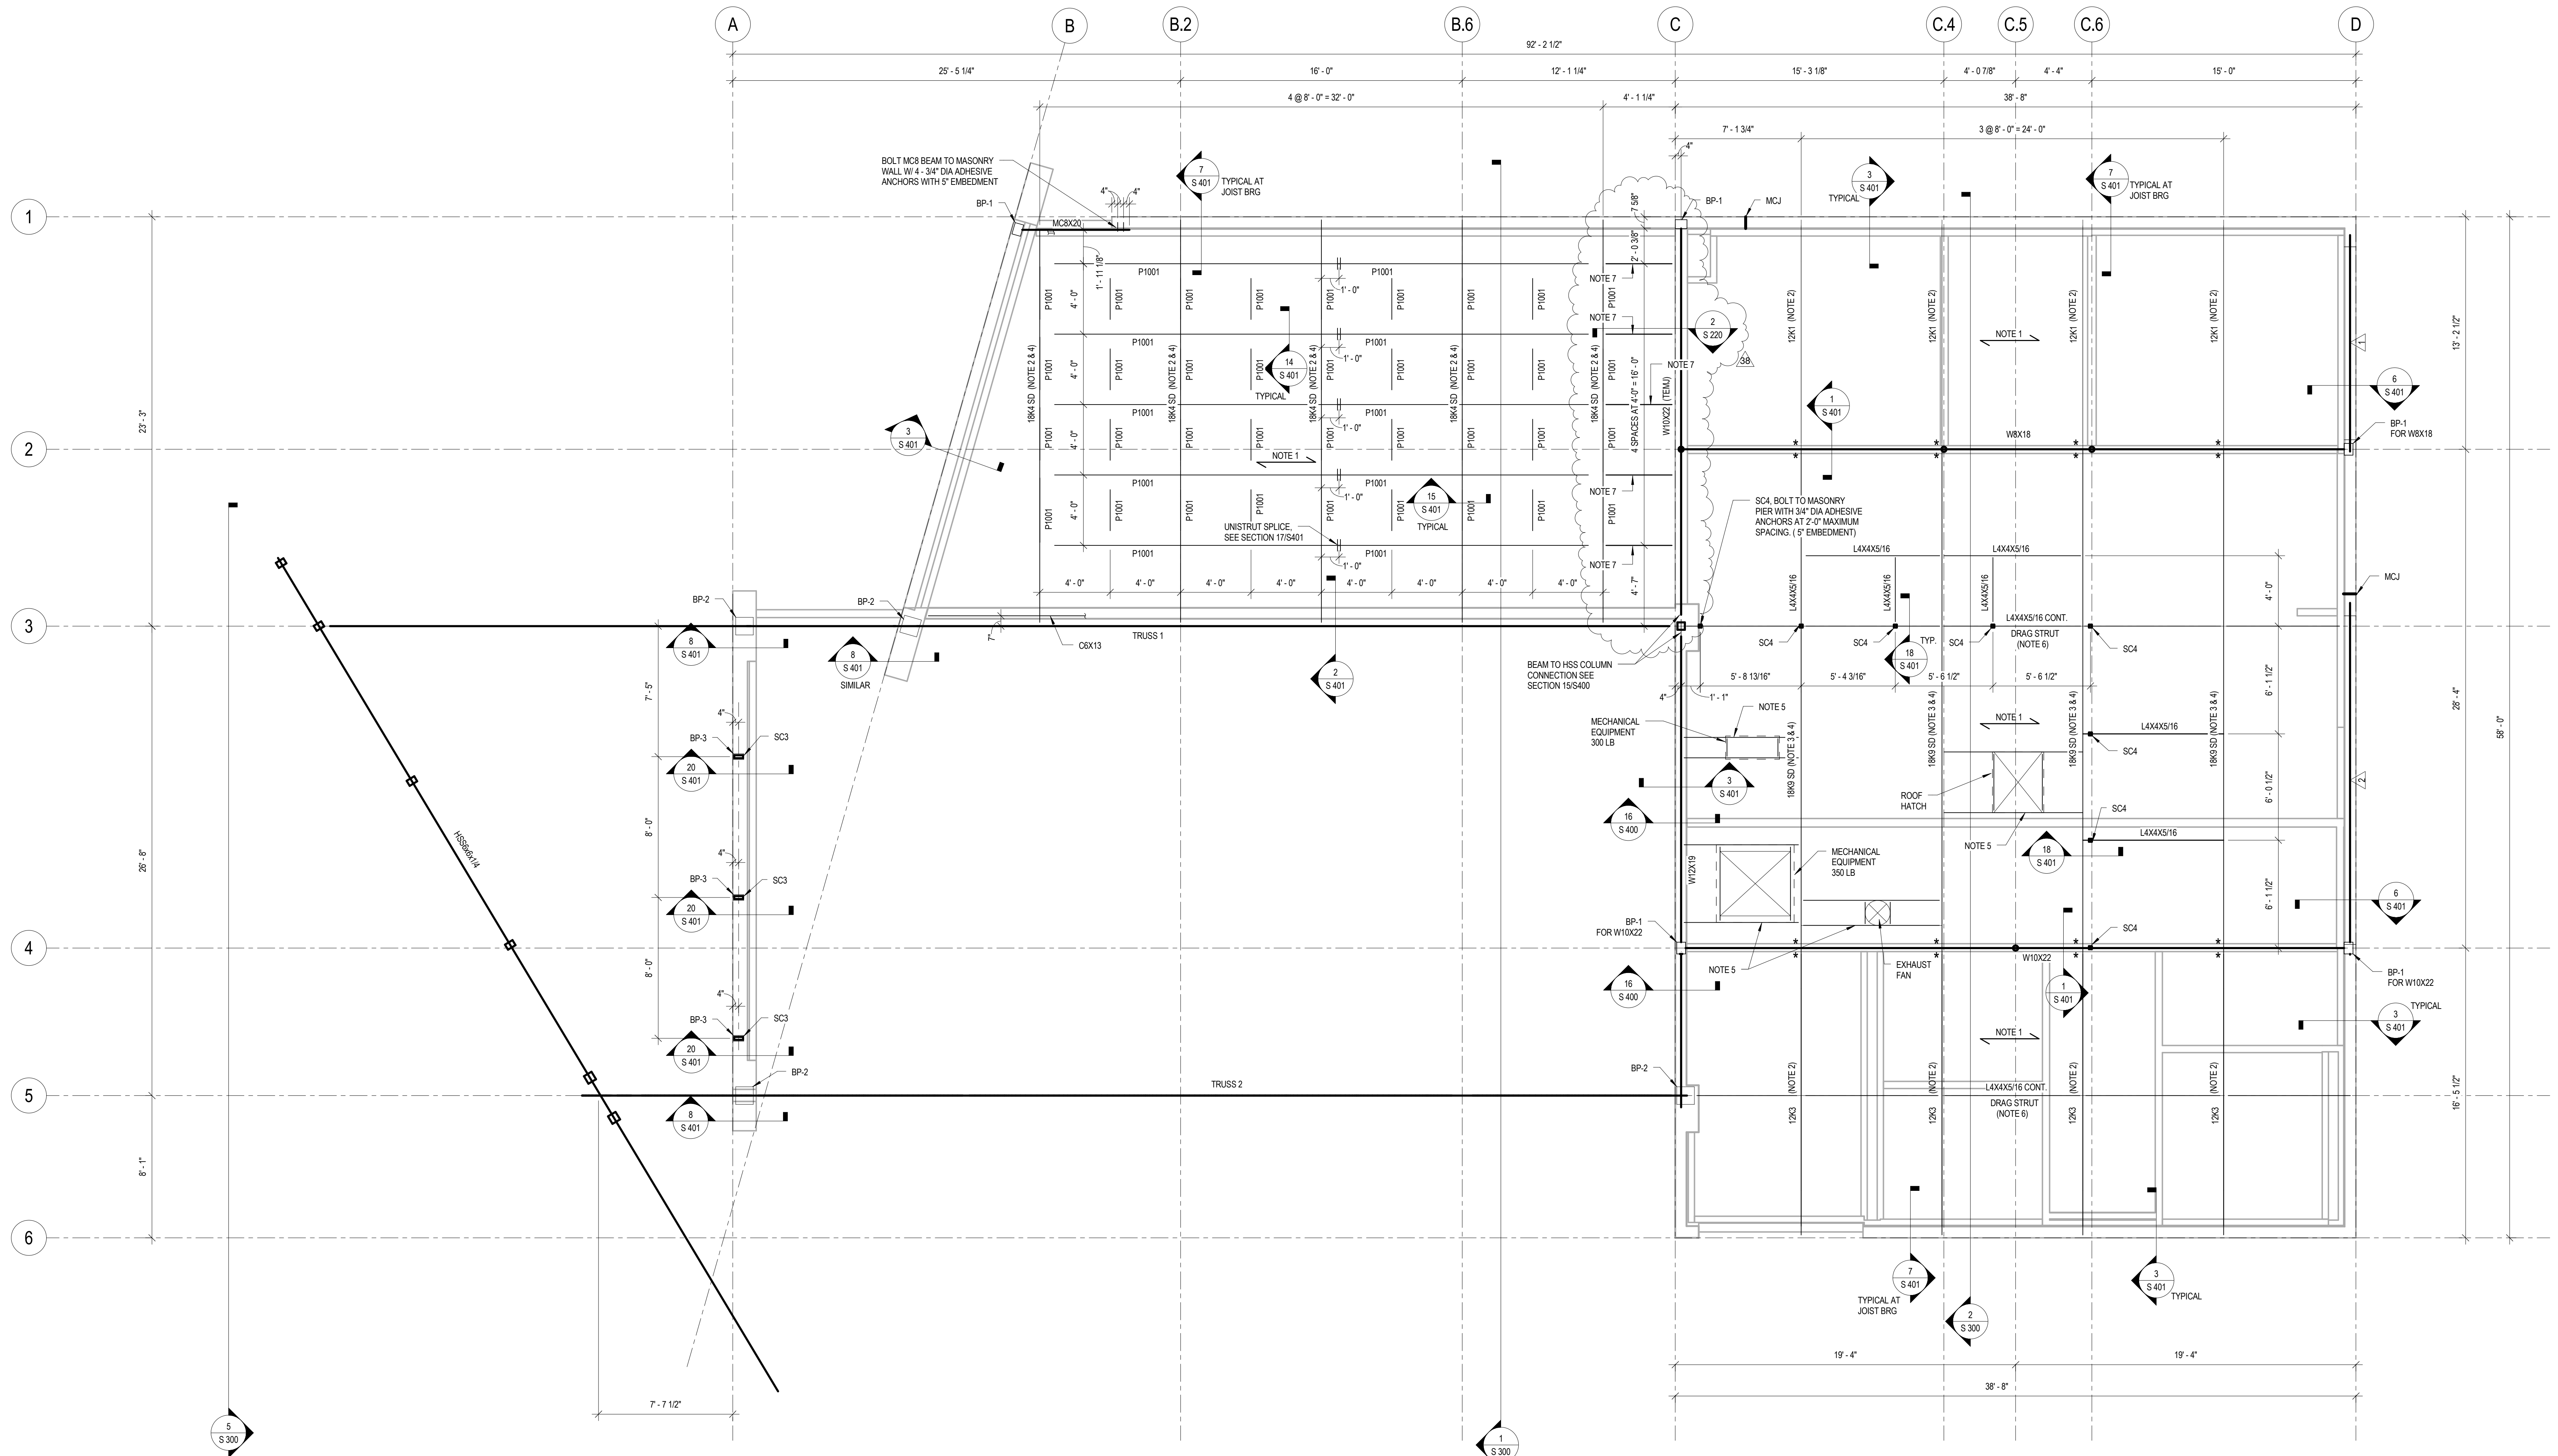


1 LOWER ROOF FRAMING PLAN


- 1/4" = 1'-0"
- SEE GENERAL NOTES ON SHEET S000 FOR ADDITIONAL INFORMATION.
- SEE ARCHITECTURAL DRAWINGS FOR DIMENSIONAL INFORMATION.
- NOTE 1 = ROOF DECK 1-1/2" x 20 GA. TYPE B
- MASONRY LINTEL MARK. SEE SCHEDULE SHEET S400.
- MASONRY WALL MARK. SEE SCHEDULE SHEET S400.
- MCJ = MASONRY CONTROL JOINT. SEE SECTION 5/S400.
- TEJU = TOP ELEVATION MATCHES JOIST.
- NOTE 2 = PROVIDE ONE ROW OF BRIDGING.
- NOTE 3 = PROVIDE TWO ROWS OF BRIDGING.
- TRUSS # = STEEL TRUSS, REFER TO TRUSS ELEVATION ON SHEET S300.
- NOTE 4 = SPECIAL DESIGN K-SERIES JOISTS, SEE 6 AND 7 ON SHEET S300 FOR DESIGN LOAD CASES.
- BP-# = BEARING PLATE, SEE SCHEDULE ON SHEET S400.
- SC4 = STEEL COLUMN, SEE STEEL COLUMN SCHEDULE ON SHEET S400.
- FOR CONCENTRATED LOADS ON JOIST GREATER THAN 200 LBS, SEE SECTION 13/S400.
- NOTE 5 = PROVIDE MECHANICAL SUBFRAME FOR ALL PENETRATIONS THROUGH ROOF, COORDINATE SIZE AND LOCATION WITH MECHANICAL CONTRACTOR, SEE SUBFRAME DETAIL, 12/S400.
- NOTE 6 = COPE VERTICAL LEG AT CONTINUOUS ANGLE AT JOIST LOCATIONS, FOR CONNECTION OF DRAG STRUT TO METAL DECK SEE SECTION 4/S220.
- NOTE 7 = HSS3X3X1/4 TRACK SUPPORT FRAMING TO BE LOCATED SO THAT SUPPORT ANGLE ENDS UP IN ROOF DECK FLUTE. MODIFY DIMENSIONS AS REQUIRED TO MATCH DECK FLUTE SPACING. SEE SECTION 2/S220 FOR ADDITIONAL DETAILING FOR MOVABLE PANEL TRACK SUPPORT STRUCTURE.

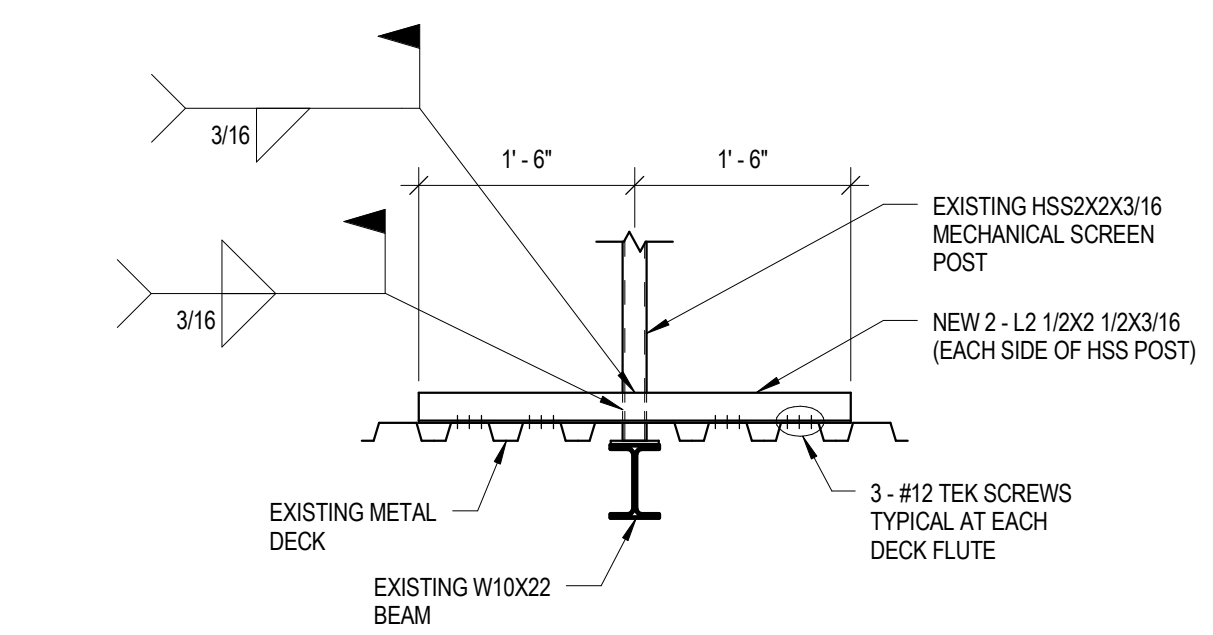

2 SECTION
3/4" = 1'-0"

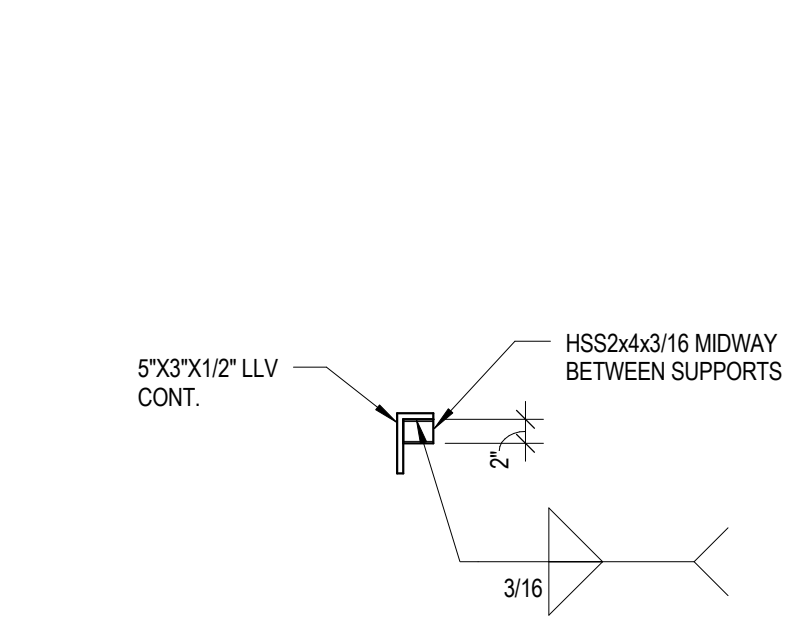

3 SECTION
3/4" = 1'-0"

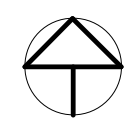


1

UPPER ROOF FRAMING PLAN

1/4" = 1'-0"


- SEE GENERAL NOTES ON SHEET S000 FOR ADDITIONAL INFORMATION.
- SEE ARCHITECTURAL DRAWINGS FOR DIMENSIONAL INFORMATION.
- NOTE 1 = ROOF DECK 1-1/2" x 20 GA. TYPE B
- FOR STANDARD BEAM TO BEAM CONNECTIONS SEE SECTION S3401.
- TRUSS # = STEEL TRUSS, REFER TO TRUSS ELEVATION ON SHEET S300.
- = MOMENT CONNECTION
- BP # = BEARING PLATE, SEE SCHEDULE ON SHEET S400.

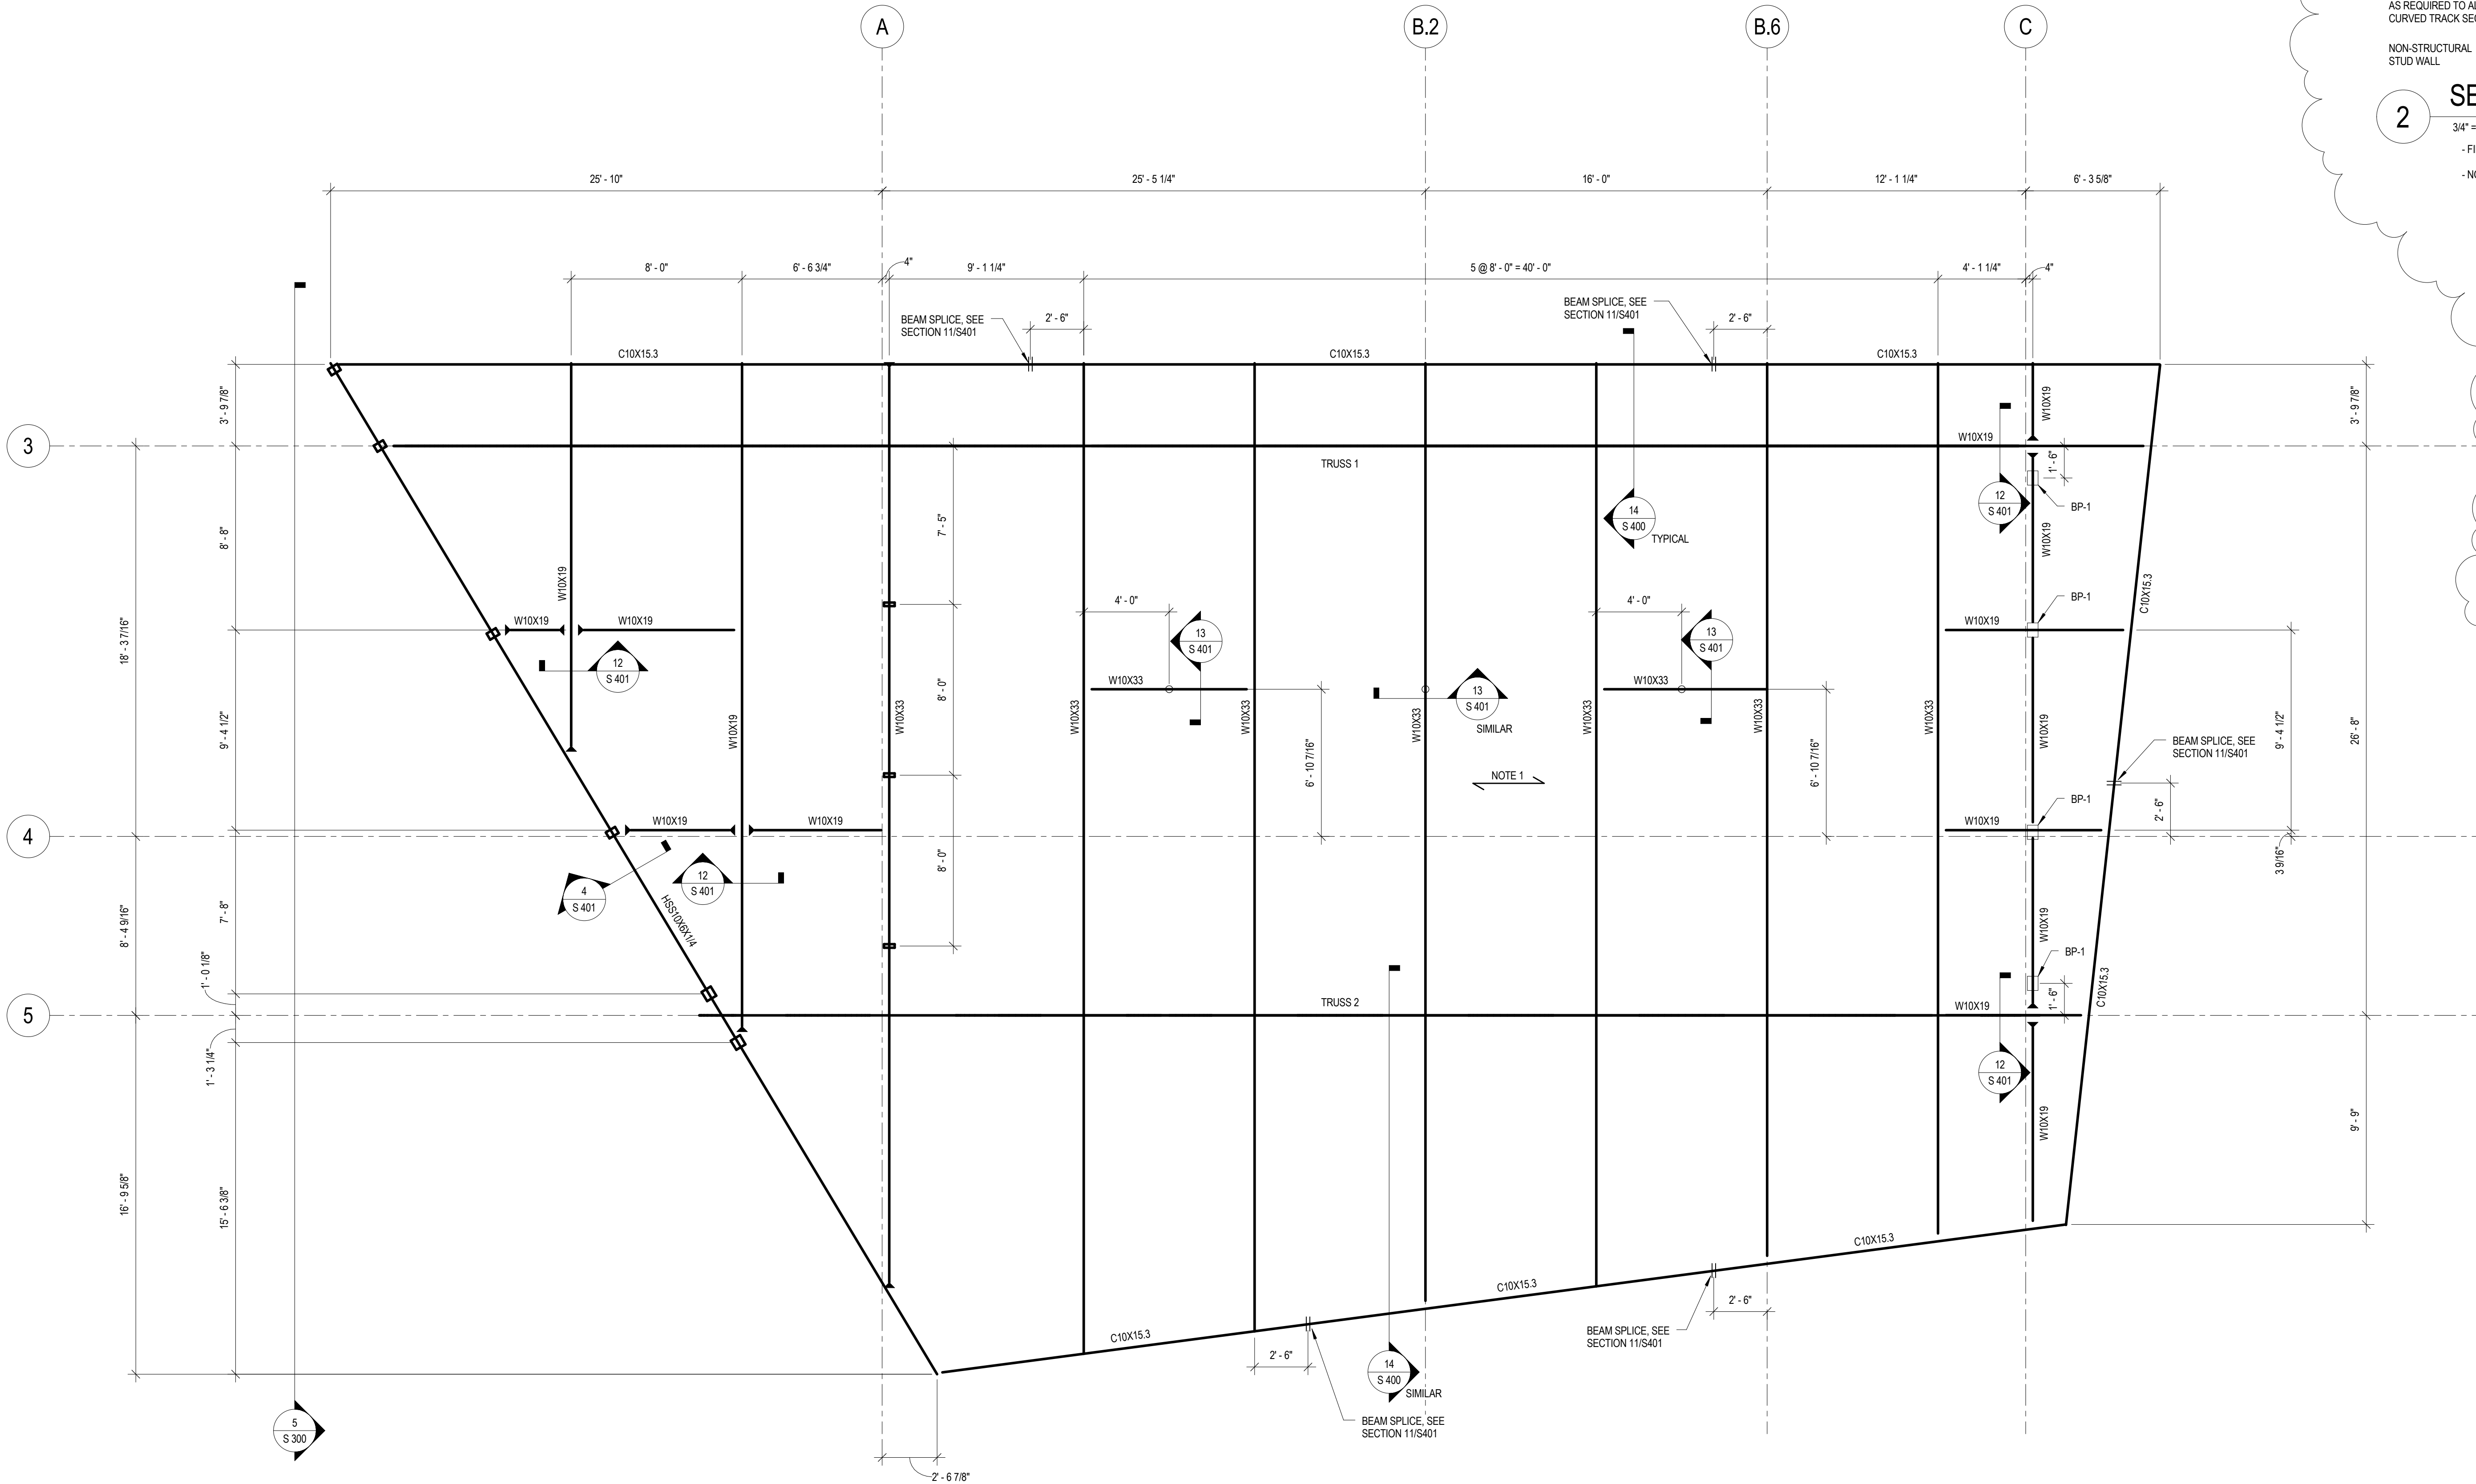

SECTION 2


3/4" = 1'-0"

- FIELD VERIFY ALL DIMENSIONS OF EXISTING STRUCTURE PRIOR TO FABRICATION.
- NOTE 1 = SEE ARCHITECTURAL PLANS FOR TRACK SUPPORT BEAM DIMENSIONS.

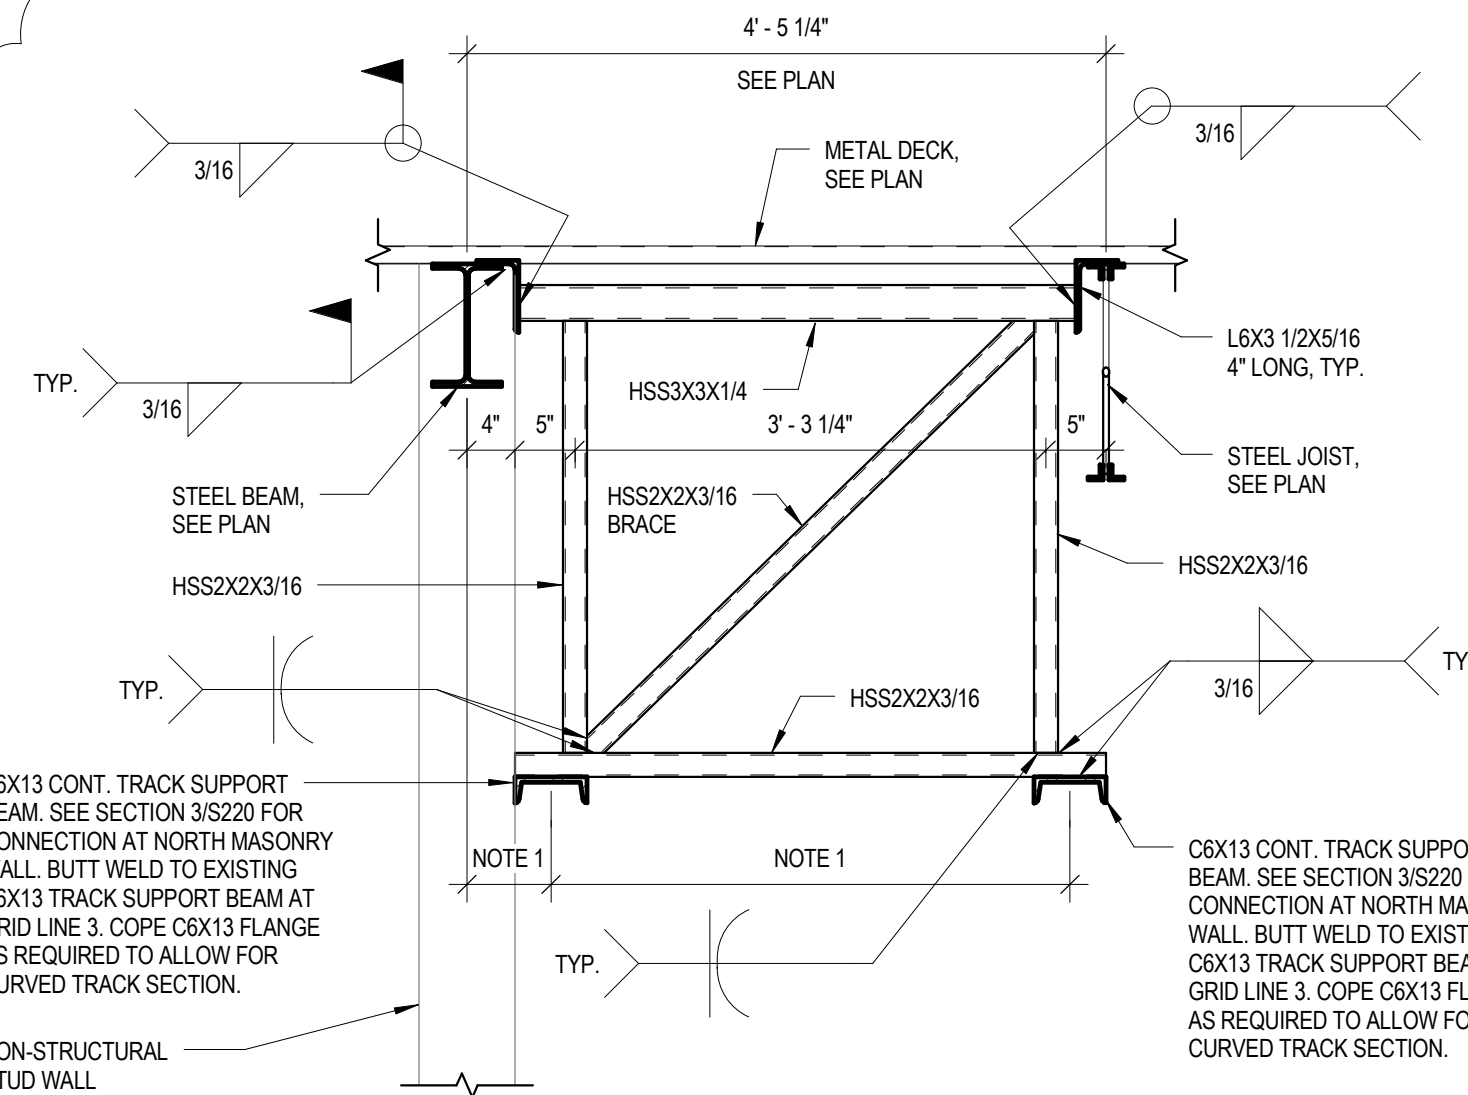


SECTION 3

3/4" = 1'-0"

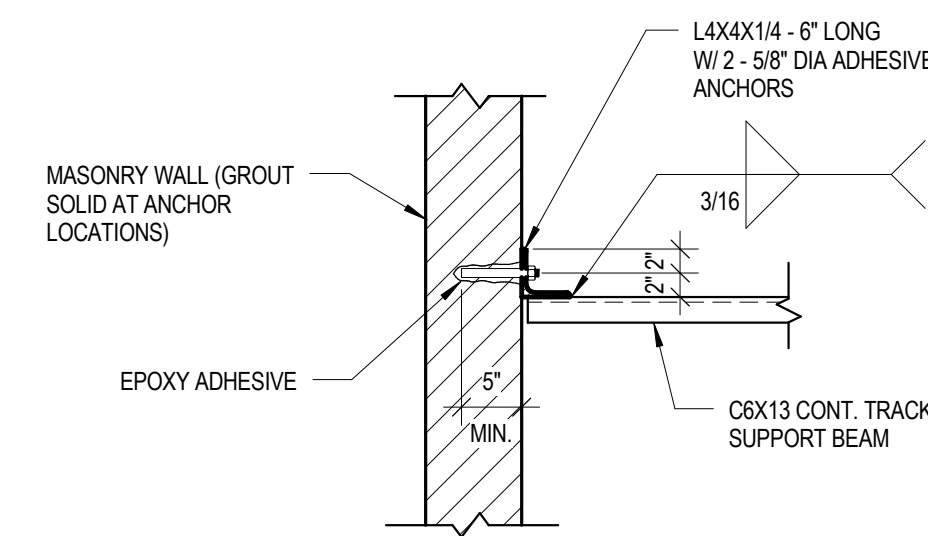

SECTION 4

3/4" = 1'-0"

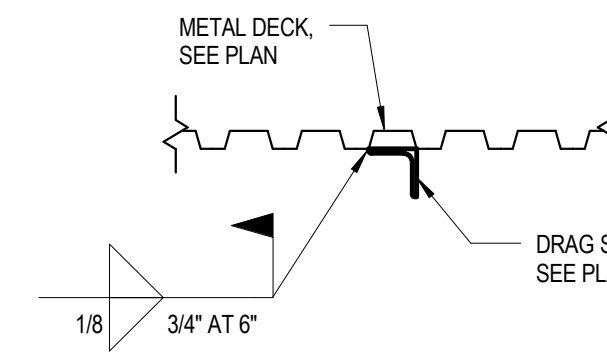

REVISIONS

No.	Description	Date
36	Owner Requested Revisions: Panel Docking Modifications	09/15/2015
37	Record Drawings	01/29/2016
38	Panel Revision	04/01/2016

100% CONSTRUCTION DOCUMENT PACKAGE

© COPYRIGHT 2011 DWL ARCHITECTS + PLANNERS, INC.


KEY:

UPPER ROOF FRAMING PLAN

SHEET NUMBER:

S 220

DRAWN BY: MSM	REVIEWED BY: RHG
DATE: 2012.05.07	PROJECT NUMBER: 5011.11.05

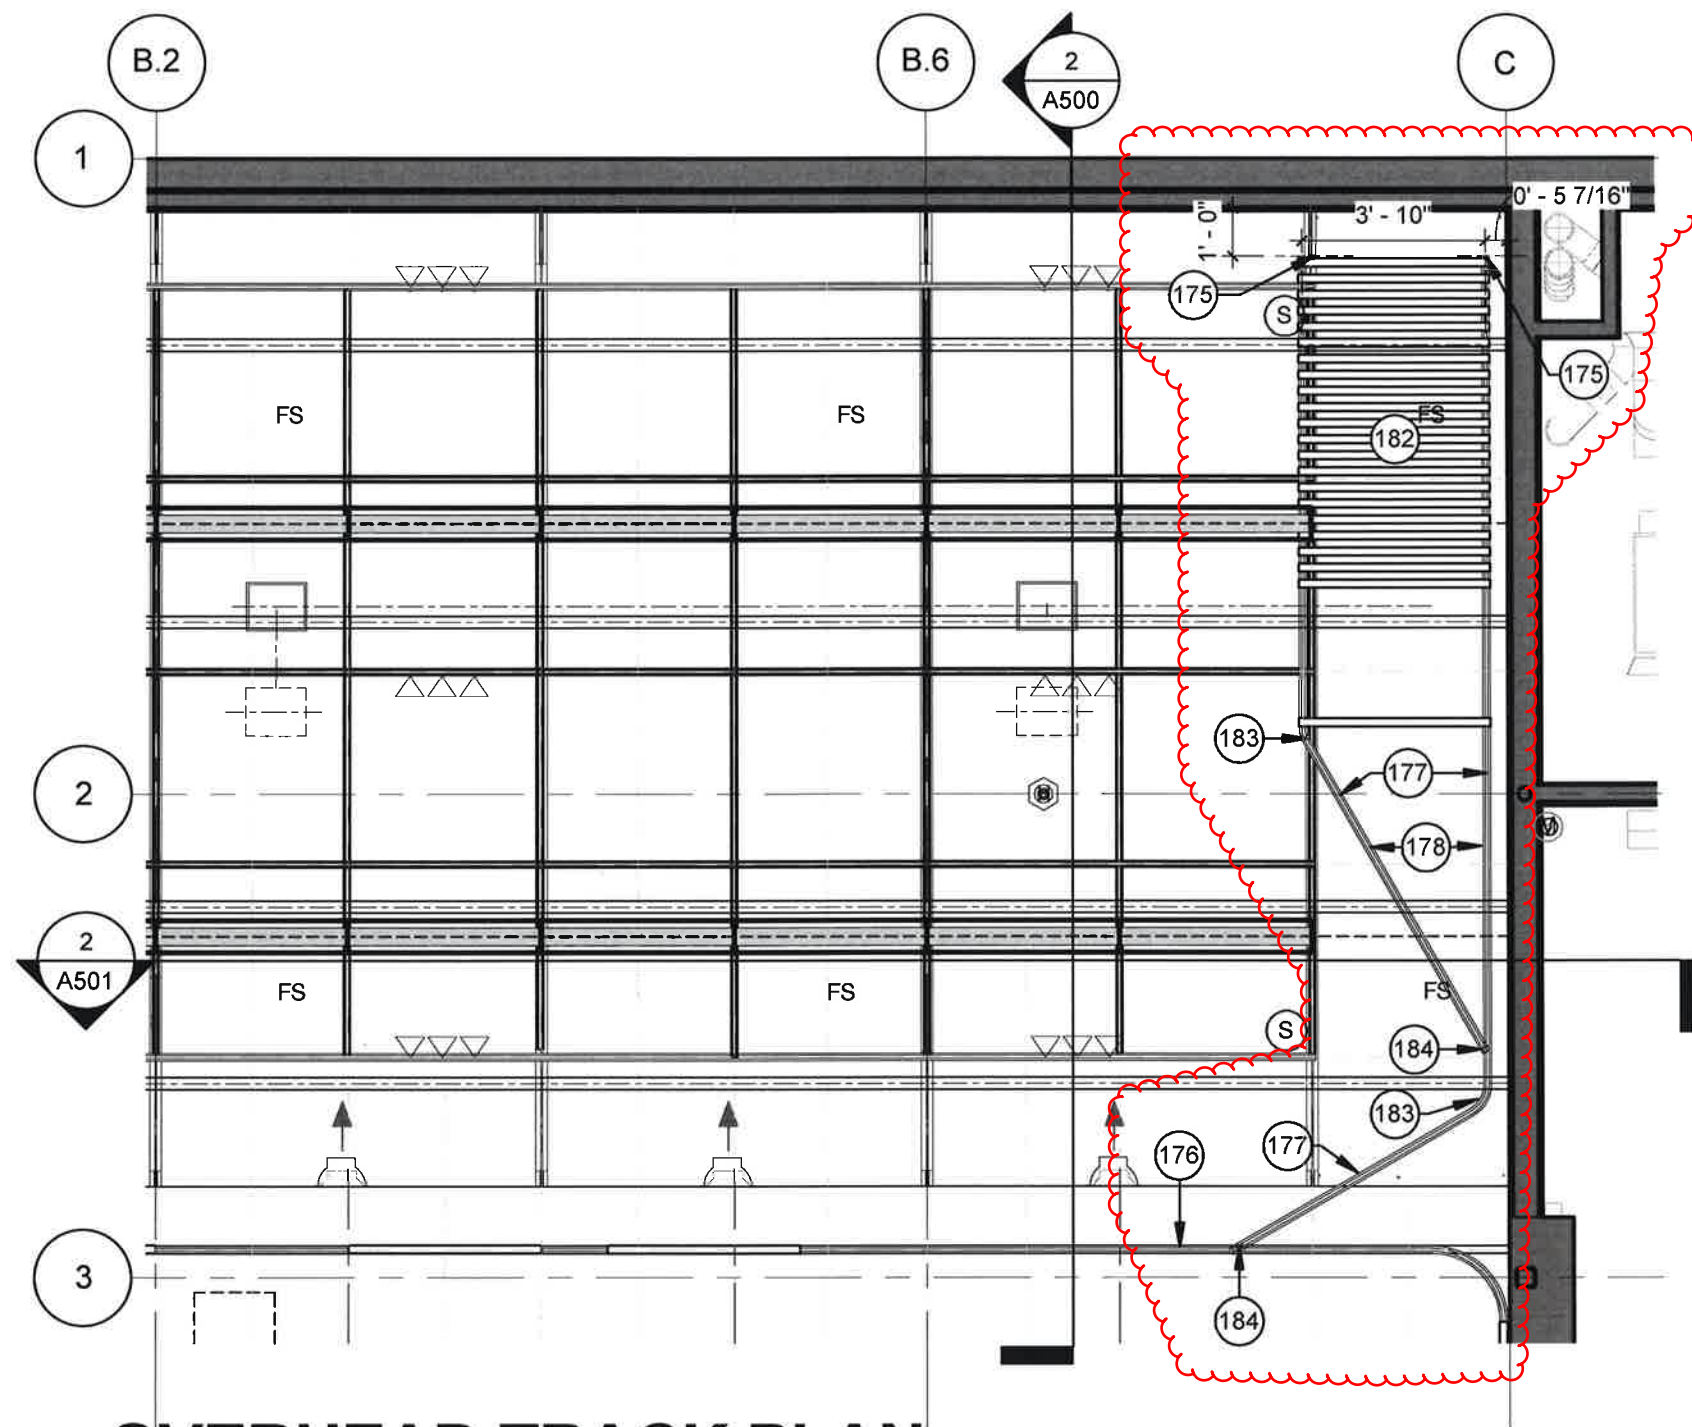

OVERHEAD TRACK PLAN

1/4" = 1'-0"

OVERHEAD TRACK GENERAL NOTES

1. ALL TRANSITIONS FROM EXISTING TO NEW TRACK ARE TO BE PROVIDED AND INSTALLED TO PROVIDE SMOOTH OPERATION WITHOUT ANY ABRUPT JUMPS OR DISRUPTIONS TO THE DISPLAY PANEL MOVEMENT.
2. TRACK TRANSITIONS AND SWITCHING TO ALLOW SMOOTH OPERATIONS IN ALL DIRECTIONS.

KEYNOTE LEGEND

- 175 PROVIDE REMOVABLE STOPS AT END OF TRACK TO ALLOW INSTALLATION AND REMOVAL OF PANELS; STOPS TO ALLOW NORTH MOST PANEL TO ALIGN WITH NORTH MOST UNISTRUT (CENTER TO CENTER)
- 176 REMOVE EXISTING ASSEMBLIES AND TRACK AS REQUIRED FOR INSTALLATION OF ADDITIONAL / MODIFIED TRACK; REPAIR AND REPLACE ASSEMBLIES PER ORIGINAL CONSTRUCTION
- 177 OVERHEAD TRACK AND COMPONENTS - MATCH EXISTING TRACK
- 178 PRIME AND PAINT TRACK AND ALL ASSOCIATED STRUCTURAL COMPONENTS PER ORIGINAL CONSTRUCTION
- 182 PROVIDE [12] NEW SLIDING DISPLAY PANELS TO MATCH EXISTING; PANELS, HARDWARE & FABRICATION TO MATCH EXISTING; SUBMIT SHOP DRWGS & HARDWARE SUBMITTALS FOR REVIEW PRIOR TO FABRICATION
- 183 NIKO PROFILE NO. 24.000 - 60° TRACK BEND; PROVIDE SHOP DRWGS TO ARCHITECT AND OWNER w/ ALL TRANSITIONS AND EXPOSED SWITCHING / MECHANISMS CLEARLY INDICATED FOR REVIEW PRIOR TO ORDERING AND INSTALLATION
- 184 NIKO 30° TOUNGE SWITCH 24.A05; PROVIDE SHOP DRWGS TO ARCHITECT AND OWNER w/ ALL TRANSITIONS AND EXPOSED SWITCHING / MECHANISMS CLEARLY INDICATED FOR REVIEW PRIOR TO ORDERING AND INSTALLATION



DRAWING DESCRIPTION:

OVERHEAD TRACK PLAN



MARICOPA COMMUNITY COLLEGE DISTRICT
THE GALLERY

1833 West Southern Avenue, Mesa,
Arizona 85202

SCALE: 1/4" = 1'-0"	DATE: 04/01/16
REFERENCE SHEET:	PROJECT NUMBER: 1118.00
ISSUED WITH:	
SHEET NUMBER: SK-20160401	

